



Schenectady County  
Purchasing Department  
**ADDENDUM**

620 State St.-2nd Floor  
Schenectady, NY 12305  
[Purchasing@schenectadycounty.com](mailto:Purchasing@schenectadycounty.com)  
518.388.4240

---

**RFB-2022-55**  
SCHENECTADY COUNTY MAIN LIBRARY AHU REPLACEMENT

**ADDENDUM #2**

9/28/2022

The purpose of this addendum is to provide detailed information to all Bidders and to answer questions. This addendum is hereby included in and made part of the Contract Documents, whether or not attached thereto. Receipt of this Addendum must be acknowledged on the bid form.

Some of the sections for AC-1 and AC-2 will be too large to fit through the access door or the duct opening called out to be removed/replaced for rigging. Please provide direction or any alternate solutions.

**Increase the existing duct opening from 50"x50" to 64"x50". See updated drawings.**

In order to rig the AHU sections to their specified locations some of the existing piping will need to be removed/replaced (drain, refill, reinsulate...). Should this work be included?

**Yes, the existing 4" chilled water supply, chilled water returns and the 3" dual water supply piping near existing AC-2 should be removed, raised, and reinstalled as high as possible. See updated drawings**

Should any alternates be awarded, can an order of importance/planned selection be provided? As it is currently designed (as individual alternates) the duct removal/replacement work would need to be included in each alternate even though the work would only need to be performed once if multiple alternates are awarded.

**Provide as currently designed. Unknown importance of alternates at this time.**

What company services the existing Fire Alarm in the building?

**Simplex**

The following documents are hereby included in the documents posted on Bidnet and provided to plan holders:

**Please acknowledge this addendum on your bid form.**

**END OF ADDENDUM #1**



Schenectady County  
Purchasing Department  
**ADDENDUM**

---

620 State St.-2nd Floor  
Schenectady, NY 12305  
[Purchasing@schenectadycounty.com](mailto:Purchasing@schenectadycounty.com)  
518.388.4240





**ENGINEERING**  
 Mechanical/Electrical Engineering Consultants  
 Capital District | Rochester | Syracuse | Buffalo  
 433 STATE STREET, SUITE 410 SCENECTADY, NY 12305 518.533.2171  
 www.meengineering.com

**SCHENECTADY COUNTY LIBRARY AHU  
 REPLACEMENT RFB-2022-55  
 99 CLINTON STREET  
 SCHENECTADY, NY 12305**



THESE DOCUMENTS AND ALL THE IDEAS, ARRANGEMENTS, DESIGNS AND PLANS INDICATED THEREON OR REPRESENTED THEREBY ARE OWNED BY AND REMAIN THE PROPERTY OF ME ENGINEERING AND NO PART THEREOF SHALL BE UTILIZED BY ANY PERSON, FIRM OR CORPORATION FOR ANY PURPOSE WHATSOEVER EXCEPT WITH THE SPECIFIC WRITTEN PERMISSION  
 2021 © ME ENGINEERING, P.C.

No.	Date	By	Description
1	09/27/22	ME	ADDENDUM #1


**DRAWING TITLE**  
**BASEMENT PIPING PLAN**

**DRAWING NO.**  
**M200**  
 Drawn By: Author  
 Checked By: Checker  
 Project Mgr: BAB  
 Project No: 213212

**ISSUE DATE**  
**09/02/2022**  
 Project Status

**DRAWING NOTES**

1. DISCONNECT PIPING AT POINT SHOWN BACK TO MAIN AS REQUIRED TO CONNECT TO COIL IN NEW WORK AIR HANDLING UNITS. PROVIDE ALL NEW VALVING PER PIPING DETAIL.
2. CONNECT CONDENSATE PIPING FROM UNIT AND ROUTE TO EXISTING FLOOR DRAIN. MODIFY FLOOR DRAIN AS REQUIRED FOR UNIT INSTALLATION.
3. IF ALTERNATE 2 IS TAKEN, DISCONNECT AND RELOCATE EXISTING 4" CWS/R AND 3" DWS PIPES IN AREA SHOWN AND REMOVE INSULATION. RISE PIPES AS HIGH AS POSSIBLE AND REINSTALL AND REINSULATE AS REQUIRED.
4. DISCONNECT AND REMOVE EXISTING ABANDONED 2" VACUUM LINE AS REQUIRED FOR UNIT INSTALLATION. CAP BOTH ENDS.

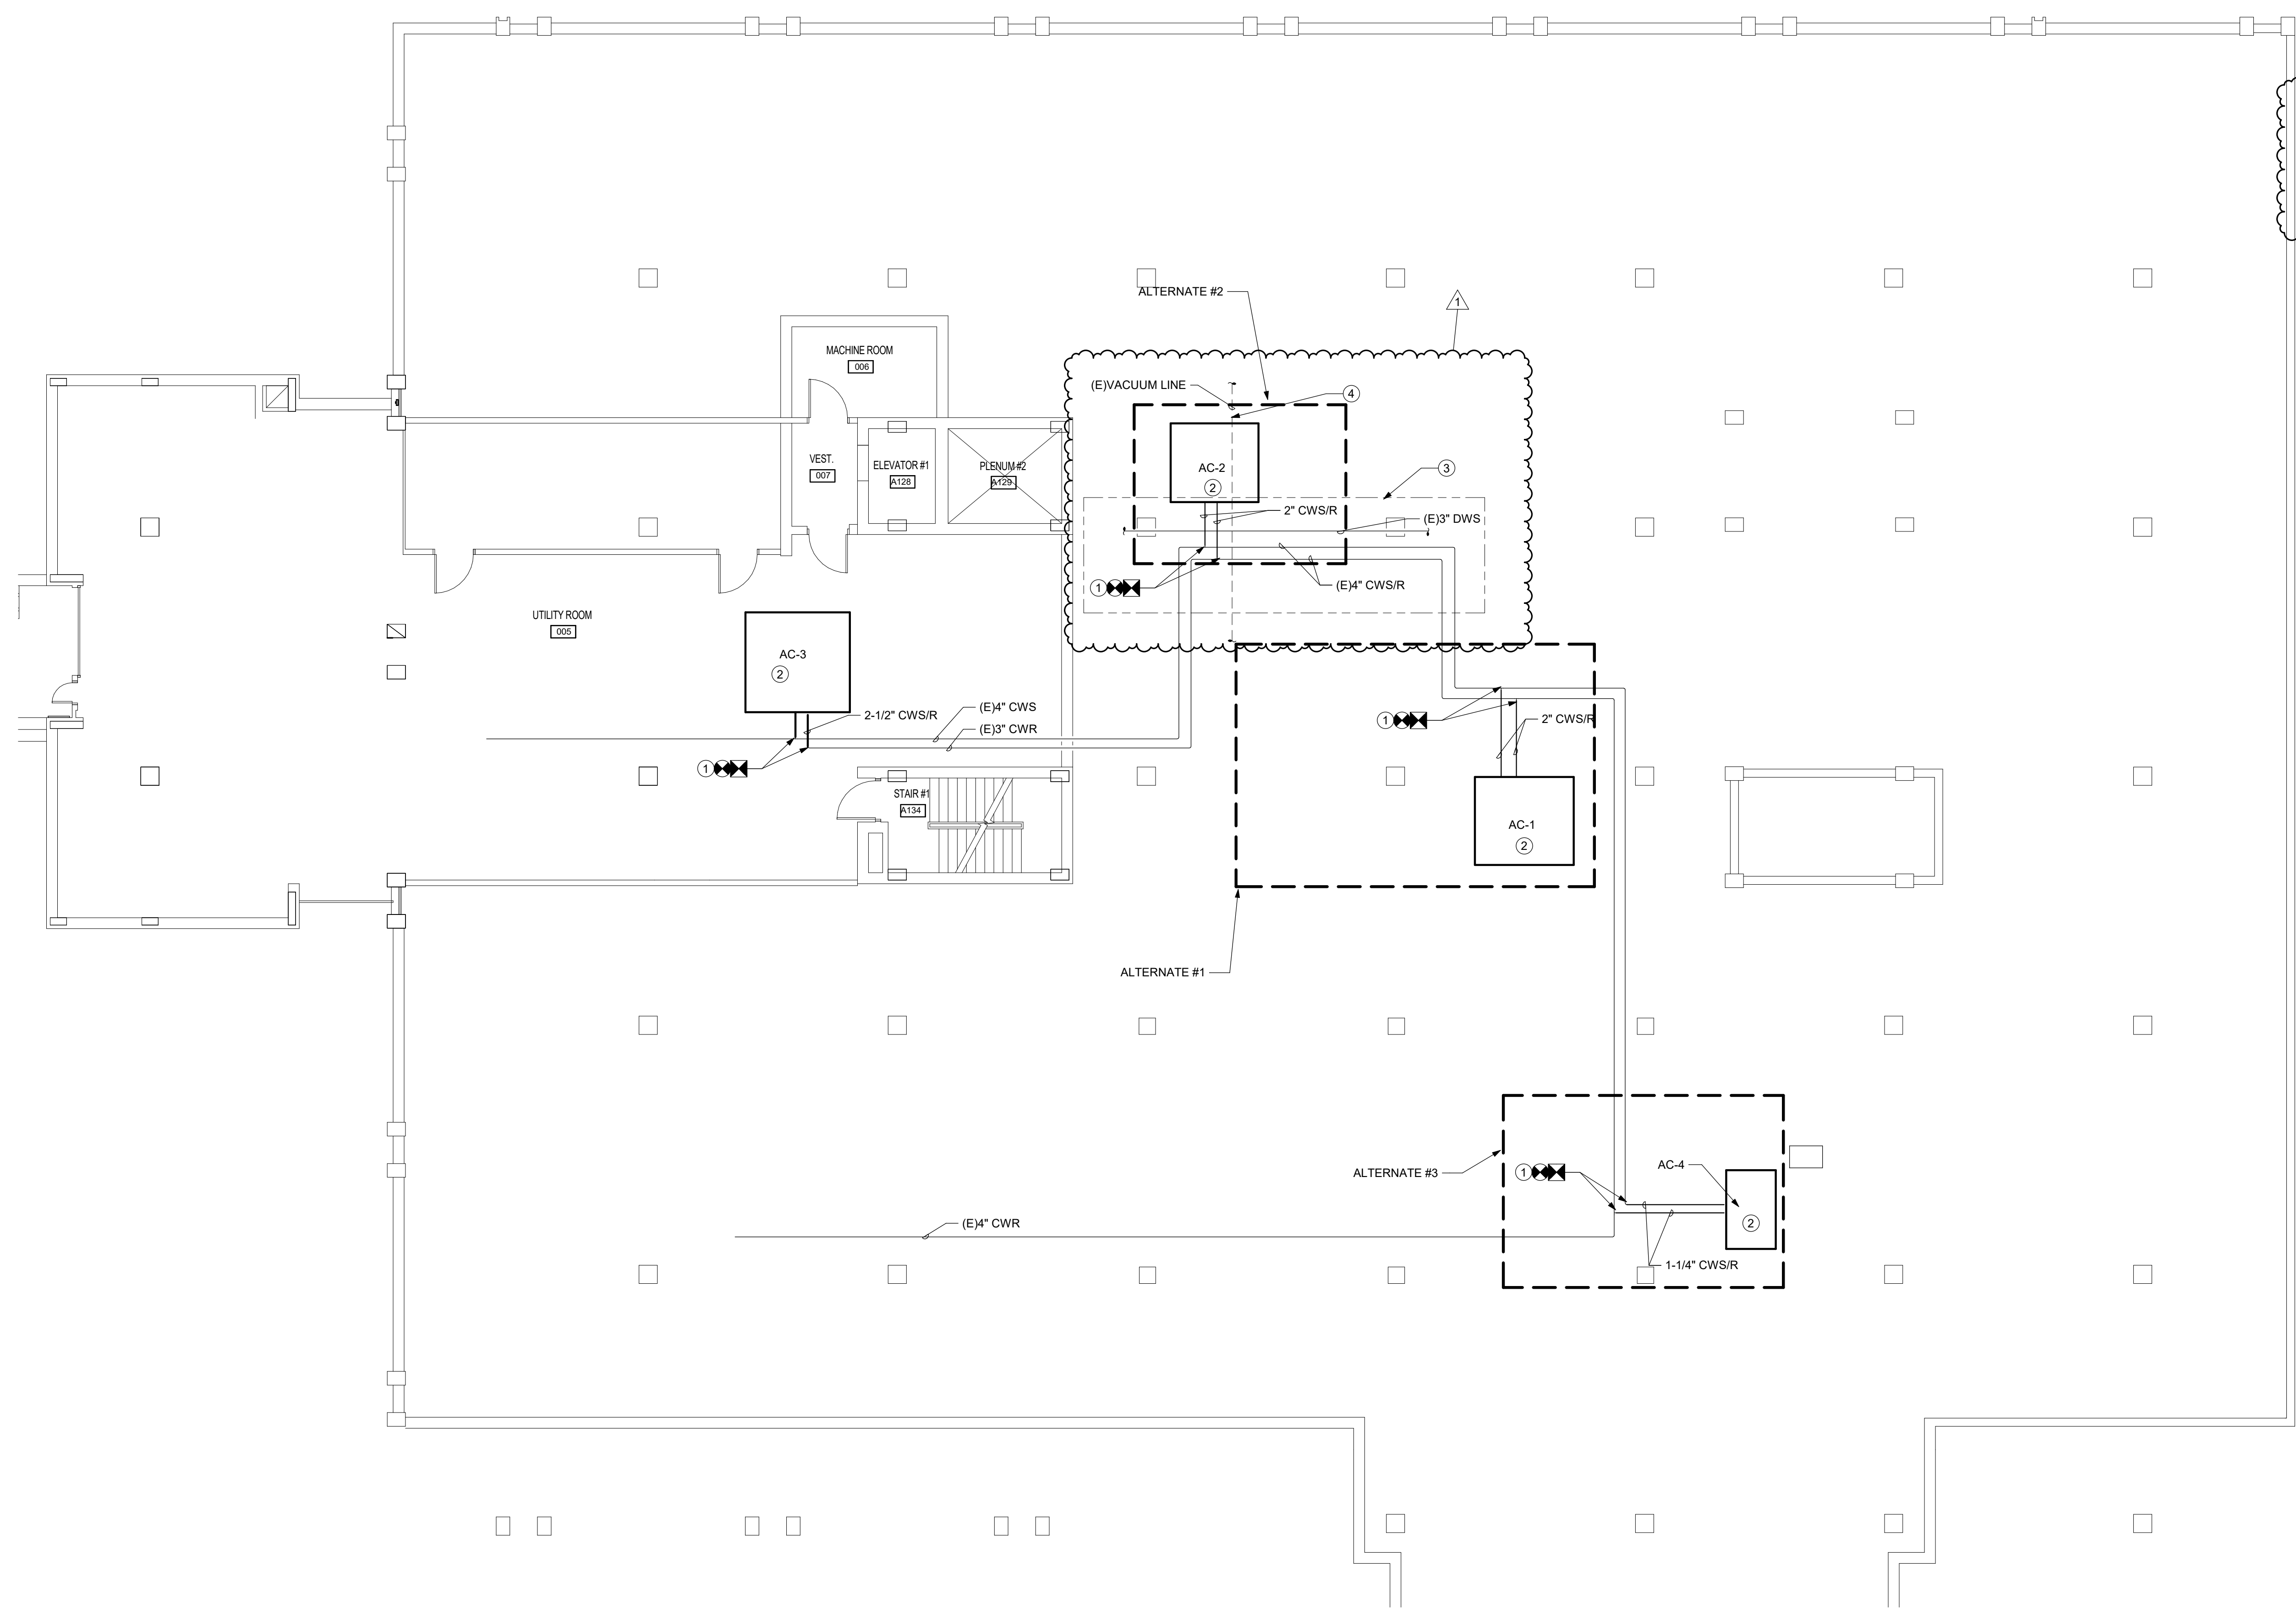

**1** Basement Piping Plan  
 1/8" = 1'-0"

